

Received by Ashfield District Council
09.12.2025




SITE LOCATION PLAN SCALE 1:500

?Crown Copyright and database rights 2025 OS Licence no. AC0000805567



SITE LOCATION PLAN SCALE 1:1250

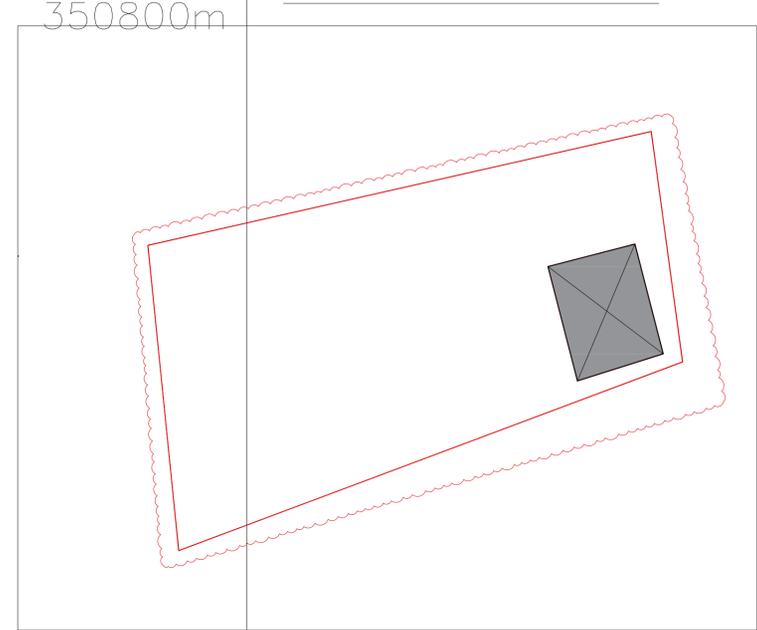

SITE LOCATION PLAN (AERIAL VIEW) NTS



SITE CONTEXT NTS

Stat.	Date.	By.	Description.
B	08/12/25	NJL	RED LINE BOUNDARY AMEND
A	29/10/25	NJL	RED LINE BOUNDARY AMENDED

This drawing is the copyright of NJL Designs and shall not be altered, copied, photographed or reproduced in any way without the written authority of NJL Designs.

Drawing Status System
A, A1, A2..... Issued for Approval/Feasibility.
B, B1, B2..... Issued for Tender Purposes.
C, C1, C2..... Approved for Construction.
D Final Issue - As Built.

Client
R Lindley
Nottingham
89 Palmerston St

Job
Rues Garage
Underwood
Nottingham
NG16 5GJ

Title
New Garage Install
Proposed Site Location
Location Plan
NG16 5GJ

Drawn NJL Chkd.
Scale 1:500/1:250 @A1 Date Oct 2025

NJL DESIGNS
MANCHESTER
M32
nathanjohnlindley@hotmail.com

DRAWING No
RLNG-4052 / 002

Rev	A	B			