


SIDE ELEVATION STREET SIDE


FRONT ELEVATION

SIDE ELEVATION

REAR ELEVATION

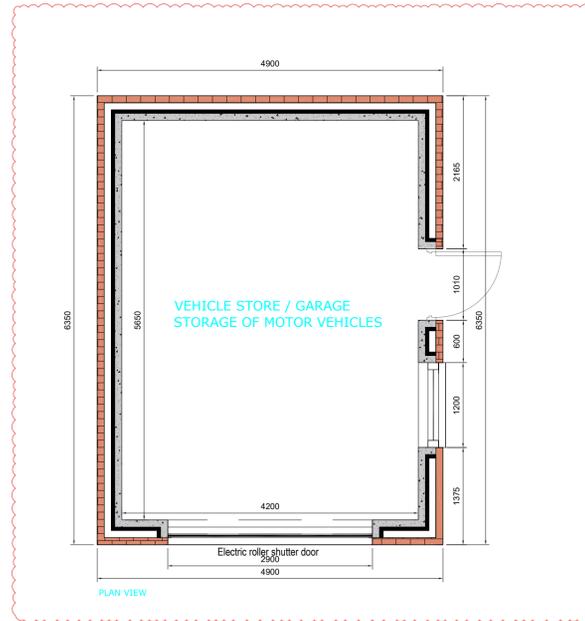

PLAN VIEW

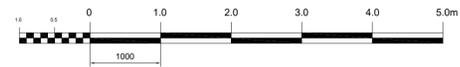

PROPOSED GARAGE DETAILS 1:50



PROPOSED LOCATION PLAN 1:100



PROPOSED IMAGE / RENDER NTS

Stat.	Date	By	Description
B	08/12/25	NJL	ADDITIONAL DIMENSIONS ADDED
A	29/10/25	NJL	Dimensions added / room purpose
<p>This drawing is the copyright of NJL Designs and shall not be altered, copied, photographed or reproduced in any way without the written authority of NJL Designs.</p> <p>Drawing Status System          A, A1, A2..... Issued for Approval/Feasibility.          B, B1, B2..... Issued for Tender Purposes.          C, C1, C2..... Approved for Construction.          D Final Issue - As Built.</p>			
<p>Client          R Lindley          Nottingham          89 Palmerston St</p>			
<p>Job          Rues Garage          Underwood          Nottingham          NG16 5GJ</p>			
<p>Title          New Garage Install          Proposed Garage Details          GA , Elevations</p>			
Drawn	NJL	Chkd.	
Scale	1:50/100 @ A1	Date	OCT 25
DRAWING No			
RLNG-4052 / 003			
Rev	A	B	